
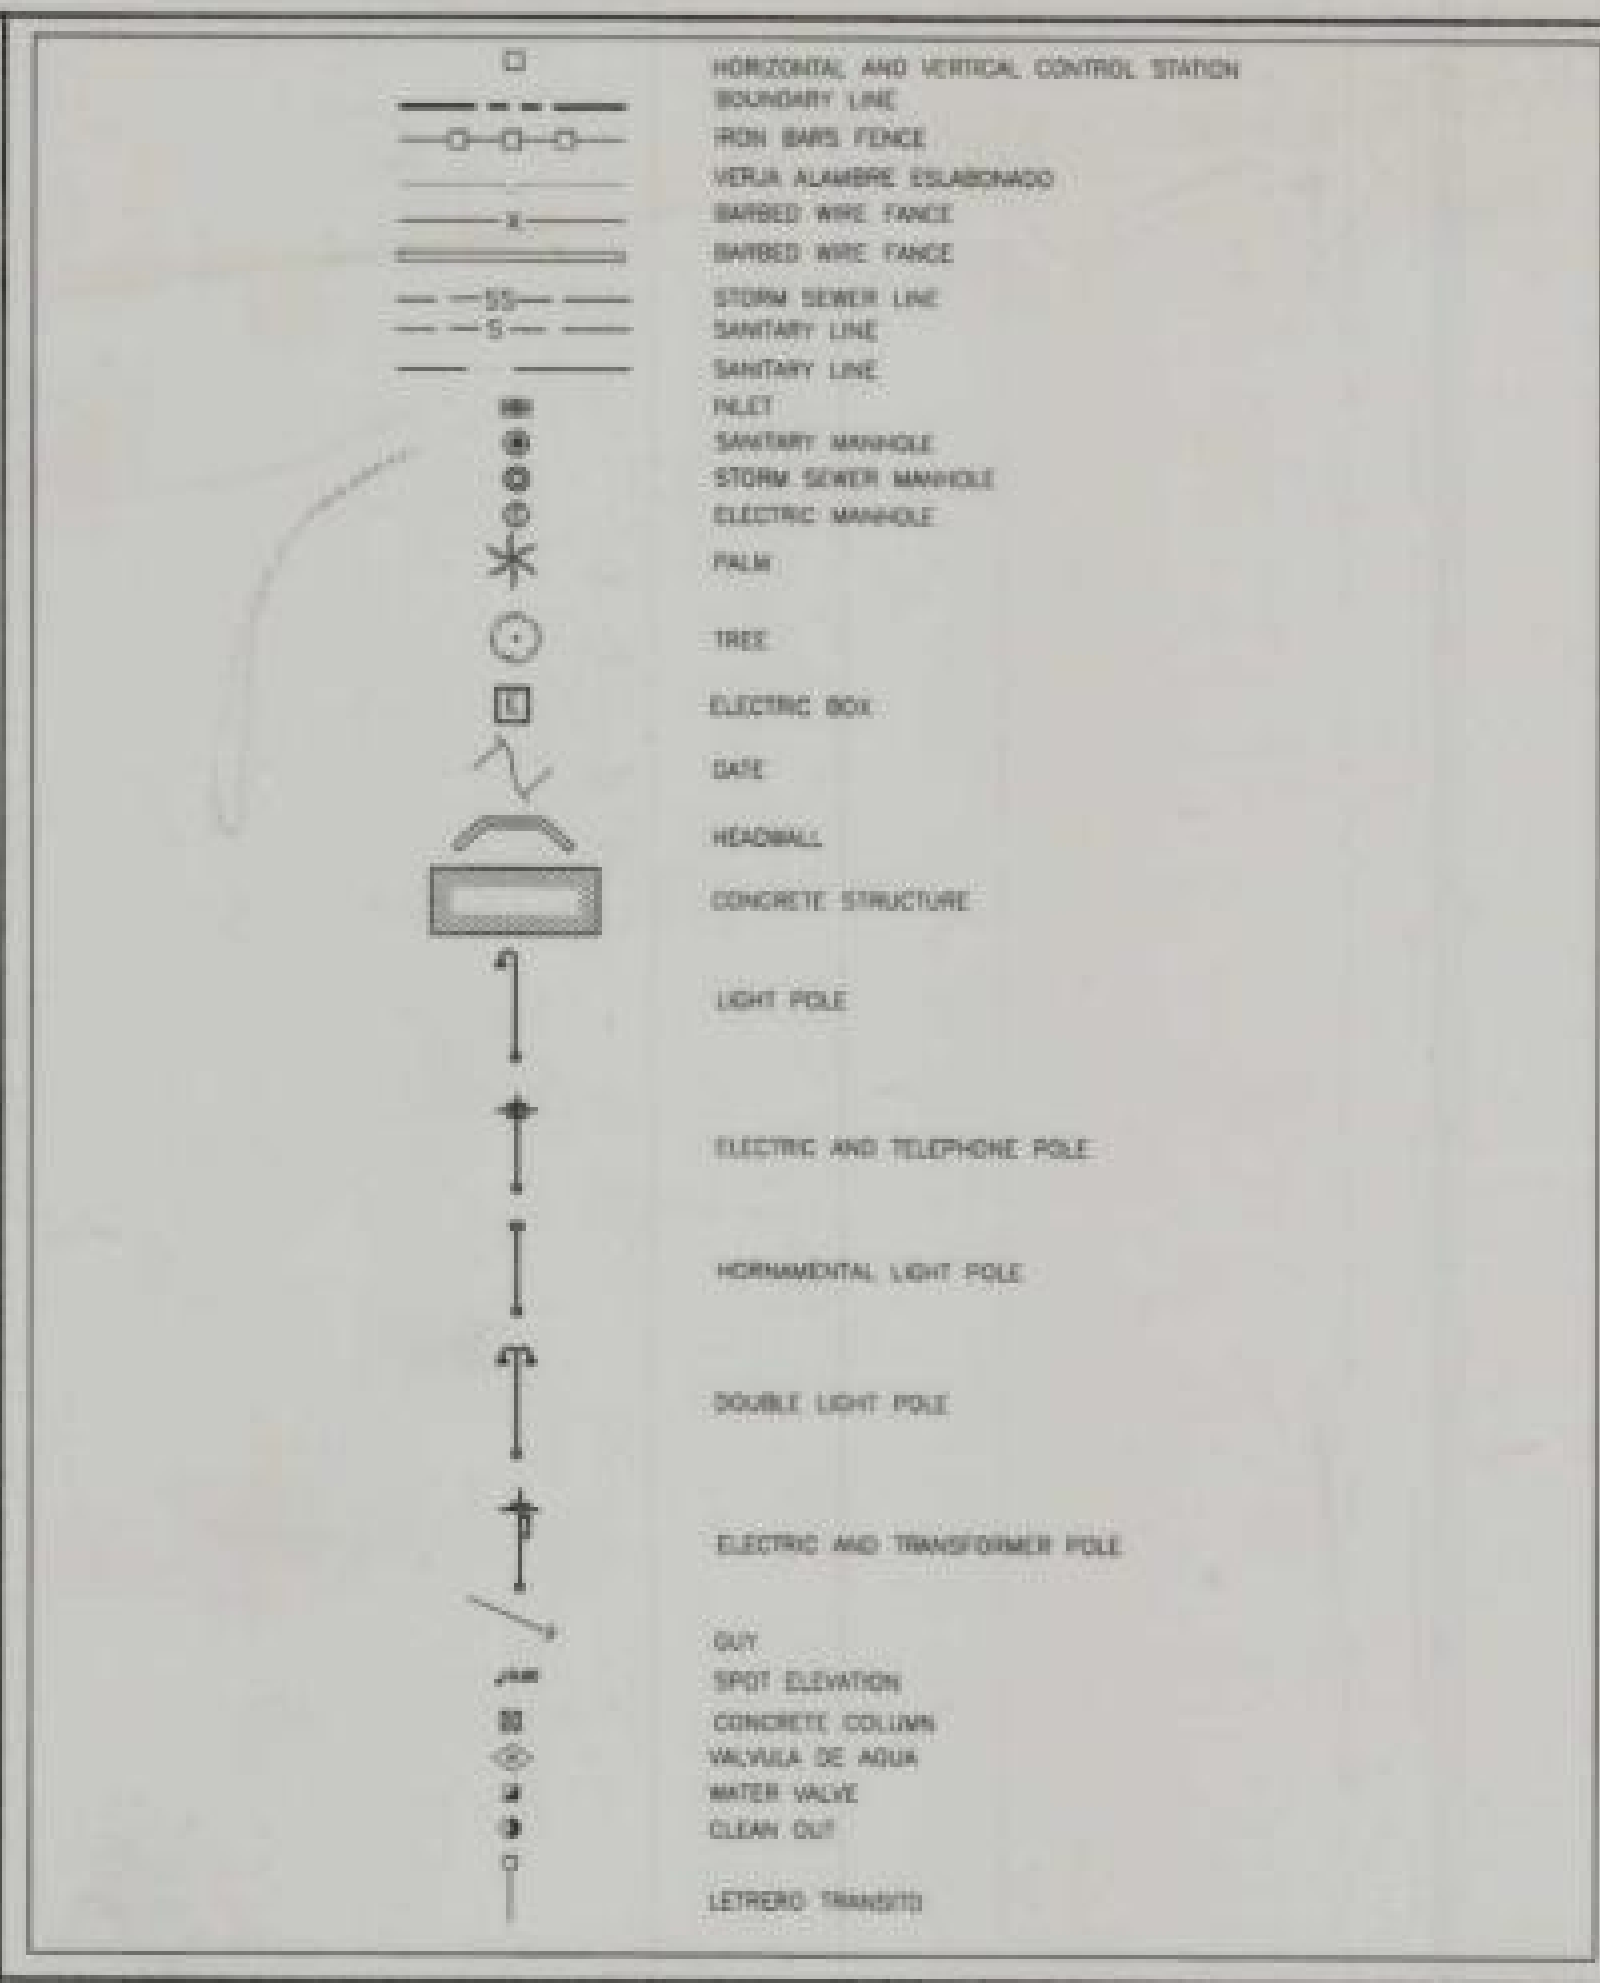


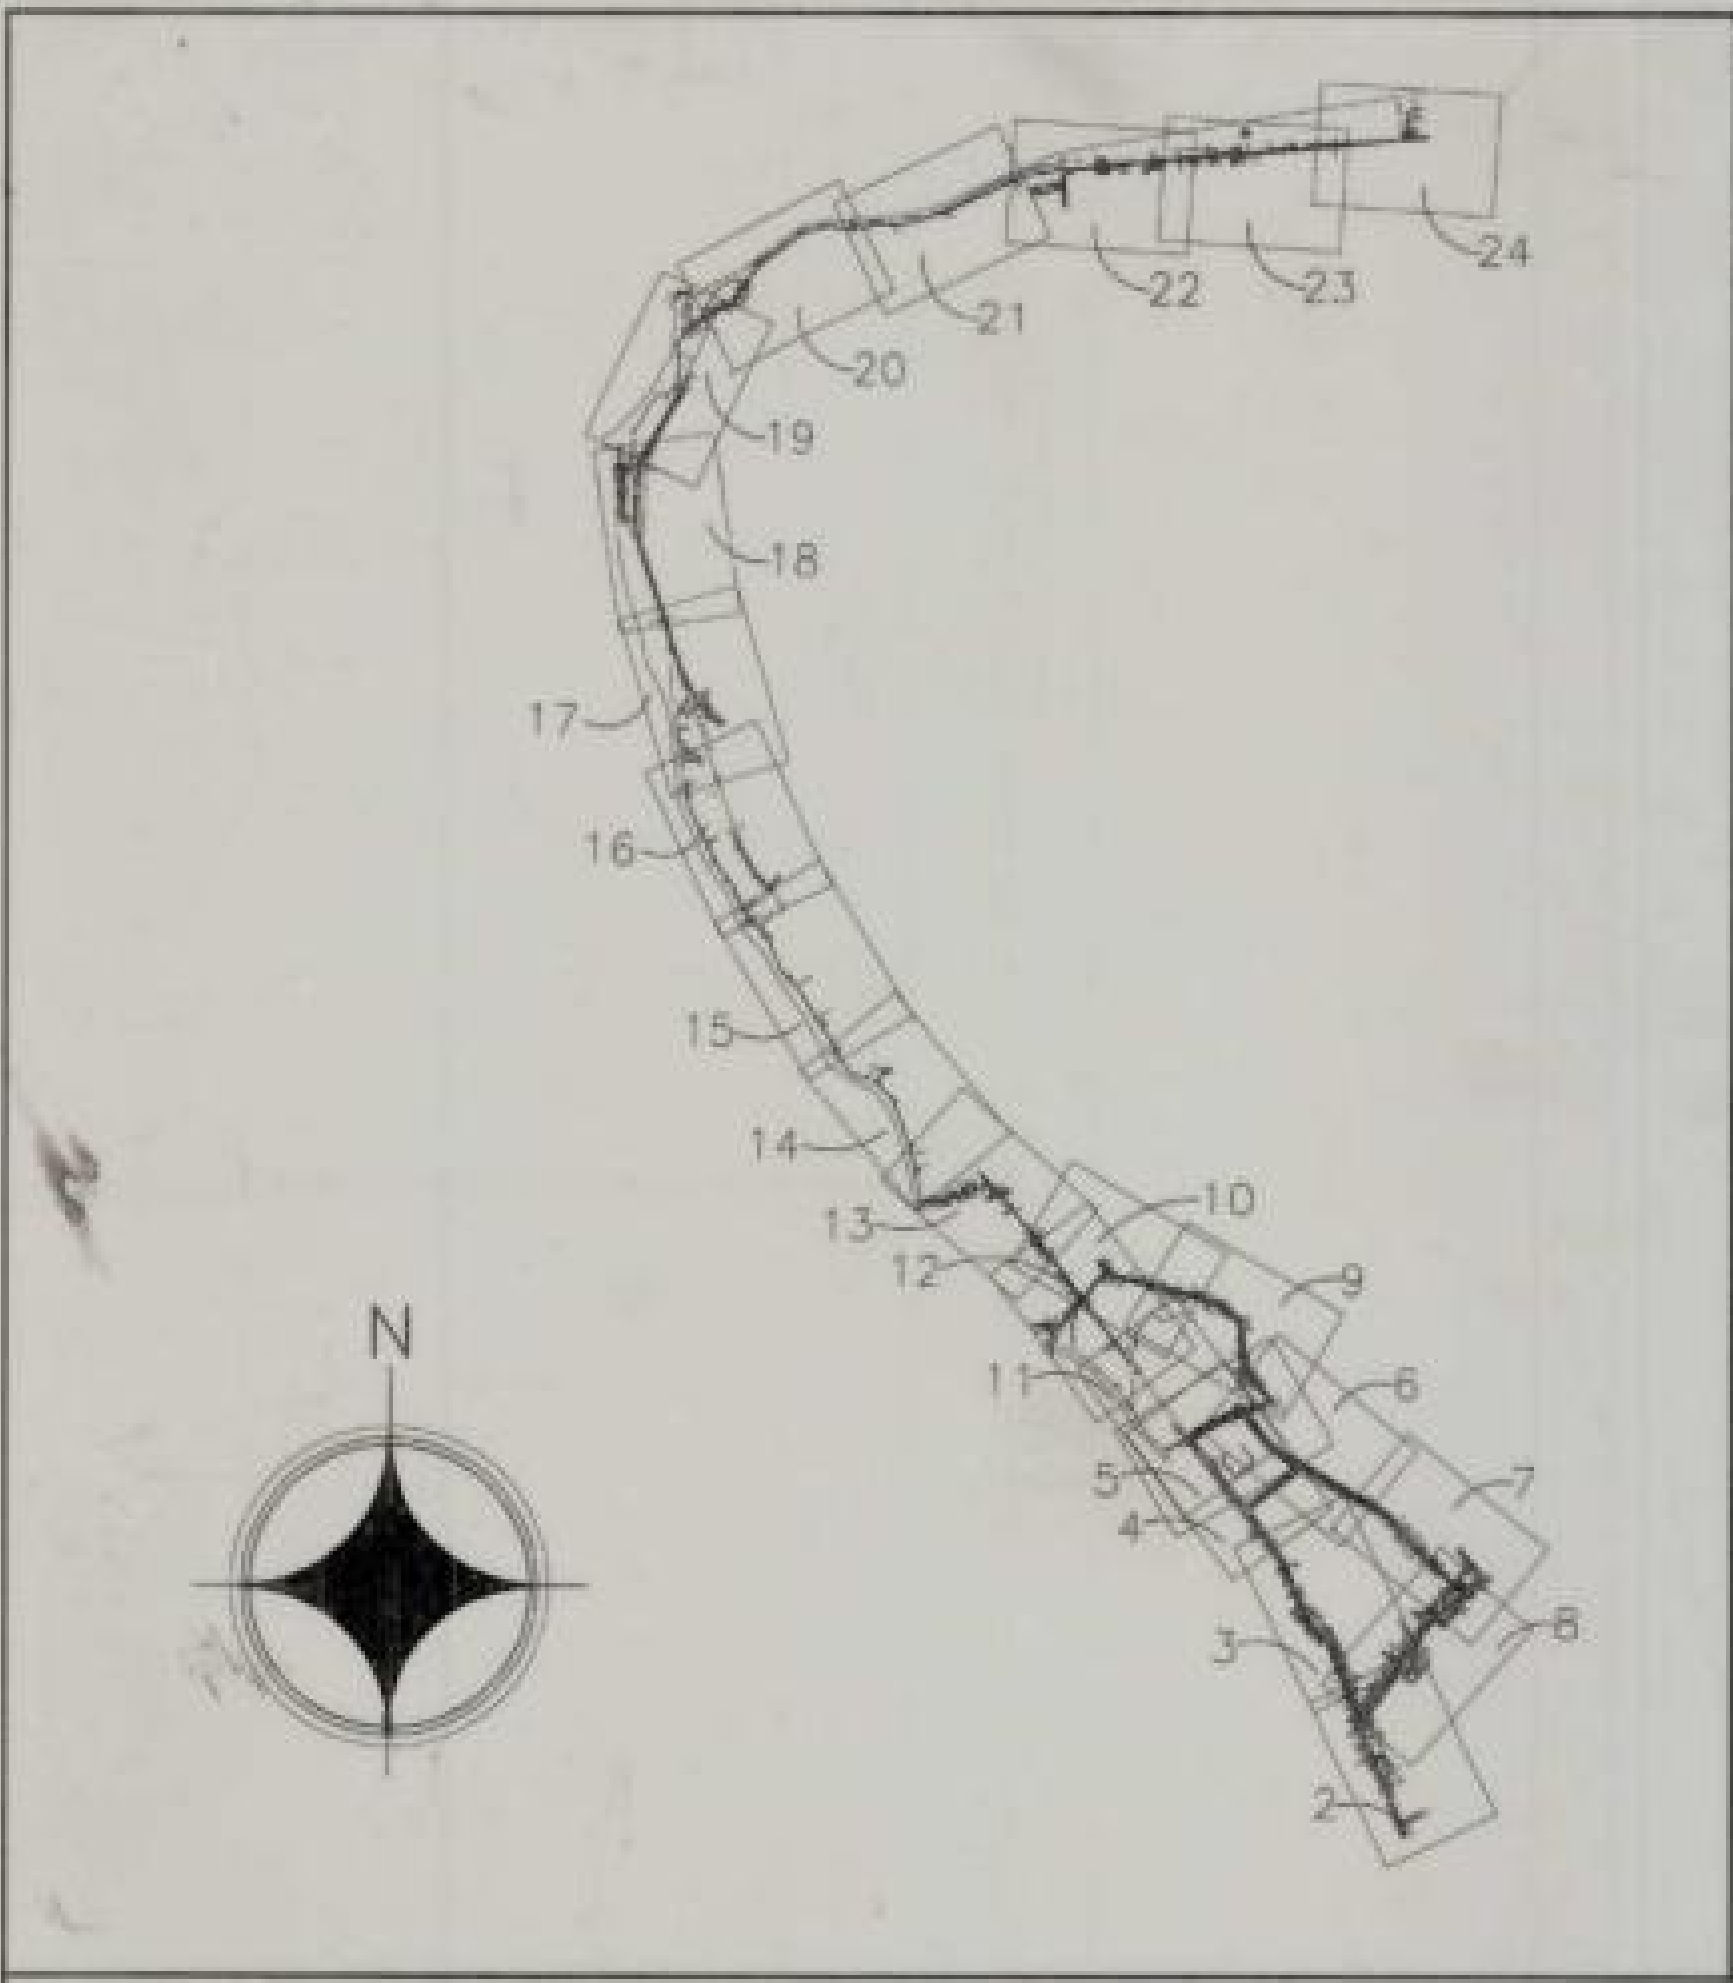

1- ALL DISTANCES EXPRESSED IN METER.
 2- HORIZONTAL CONTROL ARE REFERRED TO LAMBERT COORDINATES SYSTEM.
 3- VERTICAL CONTROL ARE REFERRED TO MEAN SEA LEVEL 1927 DATUM OF PUERTO RICO.
 4- THE SURVEY WAS CARRIED OUT WITH A TOTAL STATION "LEITZ" SET-5 AND DATA COLLECTOR "PENTAX" SC-5.
 5- THE SURVEY WAS PERFORMED ON JANUARY 1998.

FED. AID HWY PROJECT NO.	AC. PROJECT CODE NO.	HIGHWAY P. R. NUM	MUNICIPALITY	ISLAND	FISCAL YEAR	SHEET NO.	TOTAL SHEETS
STP-ENHA-(2)	AC-500023	P.R.-115	RINCÓN	P.R.	1997-98	1	24

KEY MAP NOT TO SCALE

LEGEND:

NOTES:

LOCATION MAP:

TOPOGRAPHIC AS-BUILT PLAN AND PROFILE OF RINCÓN BICYCLE AND PEDESTRIAN TRAIL RINCÓN PUERTO RICO




FED. AID. H'WAY PROJECT NO.	AC. PROJECT CODE NO.	HIGHWAY P. R. NUM.	MUNICIPALITY	ISLAND	FISCAL YEAR	SHEET NO.	TOTAL SHEETS
QTP-ENHA-(2)	AC-500023	P.R.-115	RINCÓN	P.R.	1997-98	13	24




HORIZONTAL & VERTICAL CONTROL STATION				
STATION	NORTH	EAST	ELEVATION	DESCRIPTION
R-4480	57263.9291	64812.1953	7.276	P.K. NAIL
R-4370	57227.7700	64878.2645	6.976	P.K. NAIL
R-4561	57322.7700	64776.1838	4.932	P.K. NAIL
R-4676	57386.7841	64703.7853	6.670	P.K. NAIL
R-4757	57372.8074	64641.9104	3.588	P.K. NAIL

MARITIME ZONE LIMIT			
POINT	NORTH (Y) COORDINATES	EAST (X) COORDINATES	DESCRIPTION
4924	57271.4888	64825.1013	CONCRETE MONUMENT
4876	57290.9940	64818.1148	FENCE
4903	57345.2538	64803.8888	FENCE
5048	57378.3238	64594.8070	FENCE

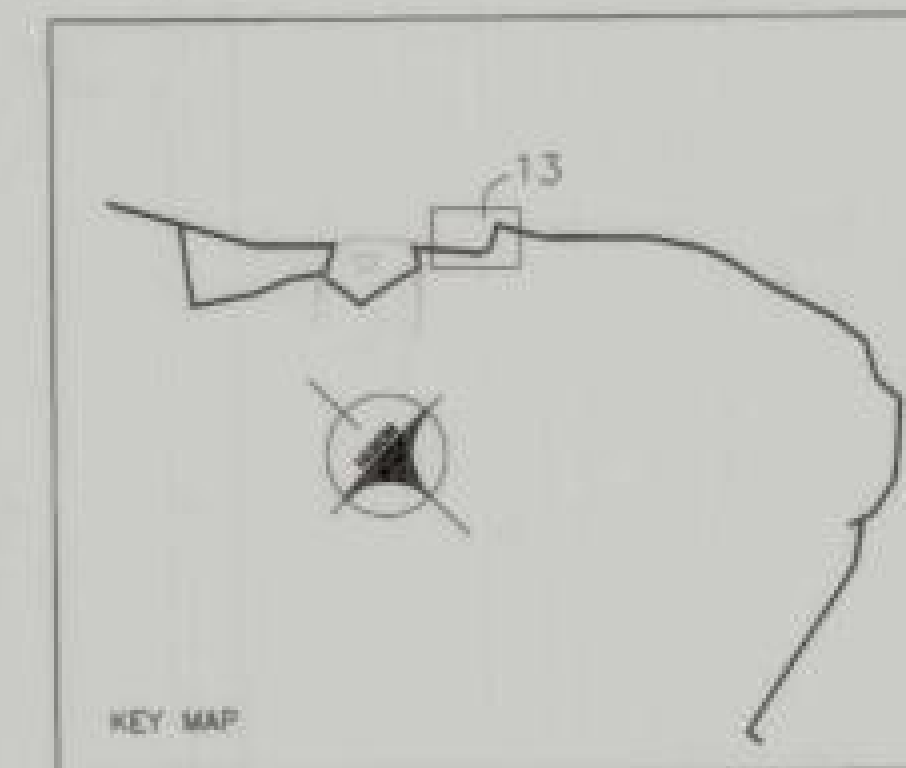

Department of Transportation and Public Works
Puerto Rico Highway
and Transportation Authority

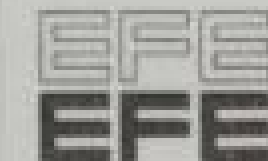

Eugenio Fernandez
Architects
(809) 751-0440
Fax (809) 751-0411
P.O. Box 3423
Guayama, P.R. 00970
E-mail: efergroup@coqui.net


Consultant:
AGRIMENSORES ASOCIADOS
SERGIO A. MORALES HERRERO
LIC. 40040

The Rincón Bicycle and Pedestrian Trail
Municipality of Rincón, Puerto Rico
SURVEY AND TOPOGRAPHIC AS-BUILT PLAN

Date	REVISIONS	File No.: 9703003.DWG
1 APRIL-16-99	GENERAL REVISIONS AND MARITIME ZONE	Plot Scale: 1:500
2		Date: July 6/98
3		Drawn By: D.P.F.
4		Revised By: S.M.M.

G
13


FED. AID H'WAY PROJECT NO.	AC. PROJECT CODE NO.	HIGHWAY P. R. NUM.	MUNICIPALITY	ISLAND	FISCAL YEAR	SHEET NO.	TOTAL SHEETS
STP-ENHA-(2)	AC-500023	P.R.-115	RINCON	P.R.	1997-98	14	24

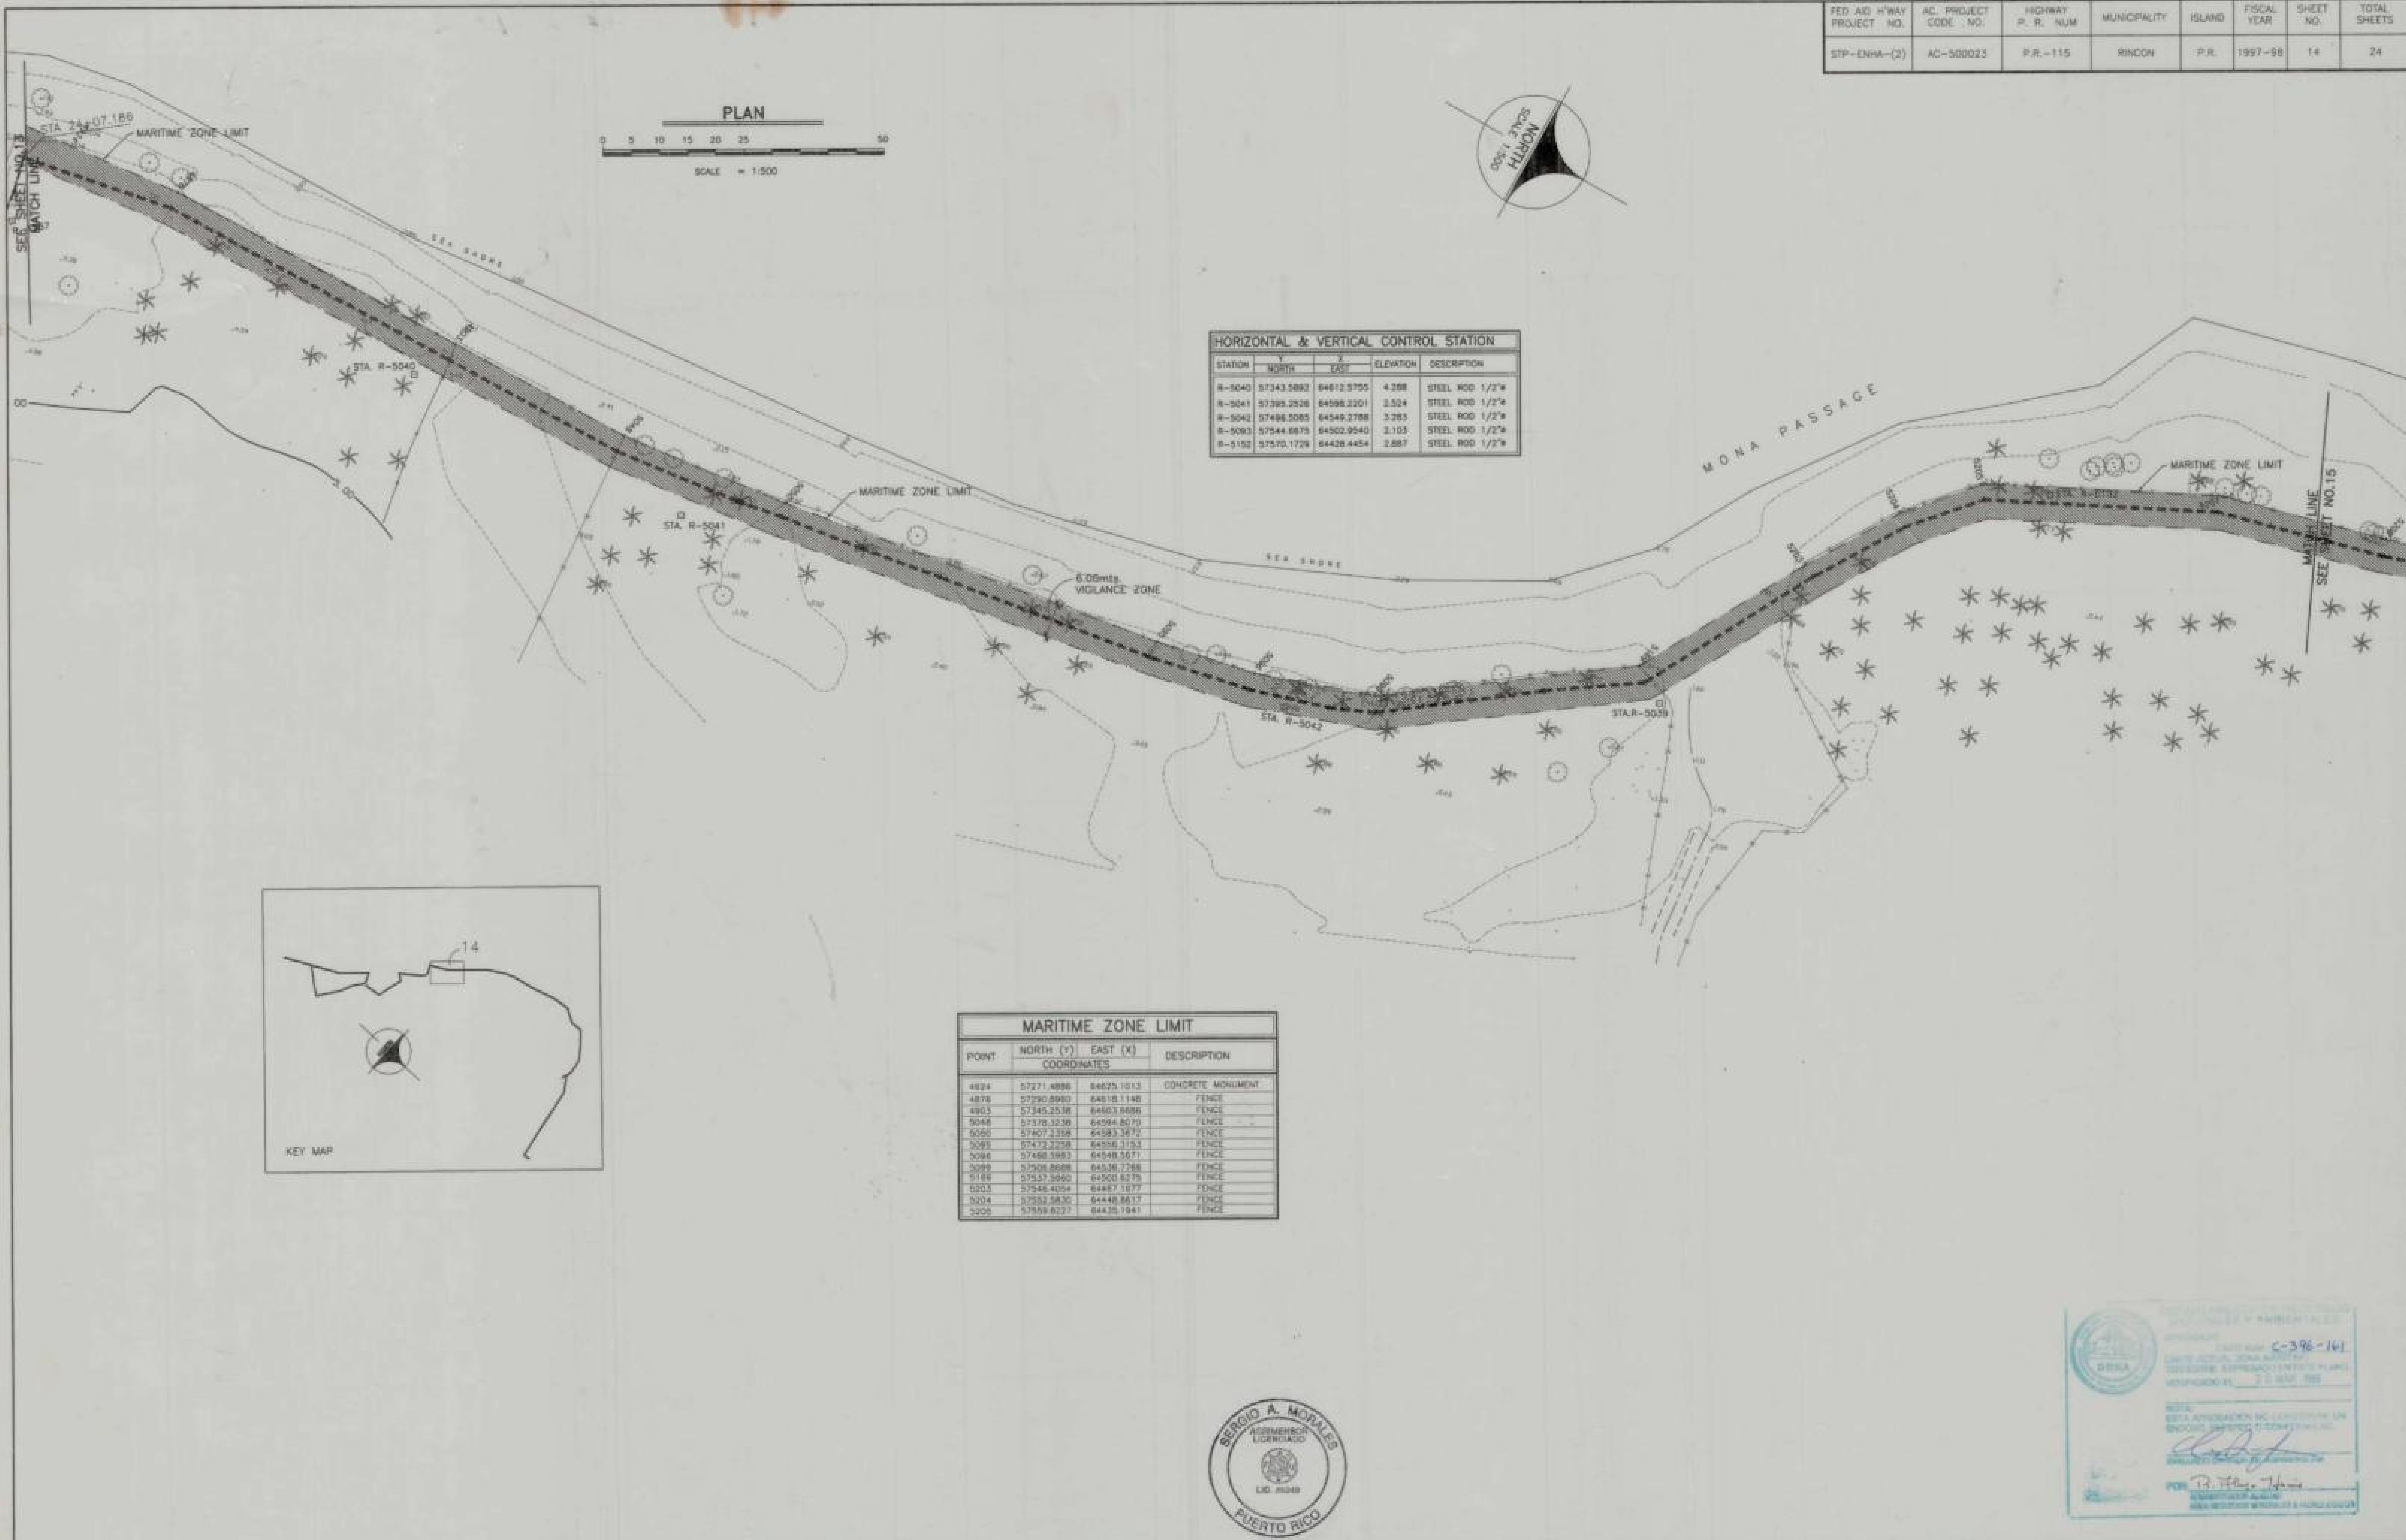

FED AID HWY PROJECT NO.	AC PROJECT CODE NO.	HIGHWAY P. R. NUM.	MUNICIPALITY	ISLAND	FISCAL YEAR	SHEET NO.	TOTAL SHEETS
STP-ENVA-(2)	AC-500023	P.R.-115	RINCON	P.R.	1997-98	15	24

MARITIME ZONE LIMIT			
POINT	NORTH (Y) COORDINATES	EAST (X) COORDINATES	DESCRIPTION
5208	57618.1418	64393.1841	CONCRETE MONUMENT
5209	57637.4559	64381.8210	CONCRETE MONUMENT
5217	57653.2780	64368.6887	CONCRETE MONUMENT
5296	57667.9183	64358.0538	CONCRETE MONUMENT
5299	57682.8553	64348.2958	CONCRETE MONUMENT
5382	57722.8746	64313.3962	TREE
5396	57748.7524	64284.7408	CONCRETE MONUMENT
5392	57762.2183	64279.8493	CONCRETE MONUMENT
5394	57790.7108	64252.3620	CONCRETE MONUMENT
5398	57805.1848	64247.5764	CONCRETE MONUMENT
5399	57819.3092	64238.7576	TREE
5425	57861.3400	64218.9543	CONCRETE MONUMENT
5457	57877.2283	64209.0374	CONCRETE MONUMENT
5468	57885.8308	64181.3244	FENCE CORNER
5472	57892.4724	64182.3172	TREE
5483	57899.4285	64178.5318	CONCRETE MONUMENT


HORIZONTAL & VERTICAL CONTROL STATION				
STATION	NORTH	EAST	ELEVATION	DESCRIPTION
R-5188	57886.8417	64371.1593	2.946	STEEL ROD 1/2"
R-5299	57799.8982	64283.0108	2.818	STEEL ROD 1/2"
R-5349	57858.8151	64227.9927	3.355	STEEL ROD 1/2"
R-5454	57886.2913	64172.8571	1.830	STEEL ROD 1/2"

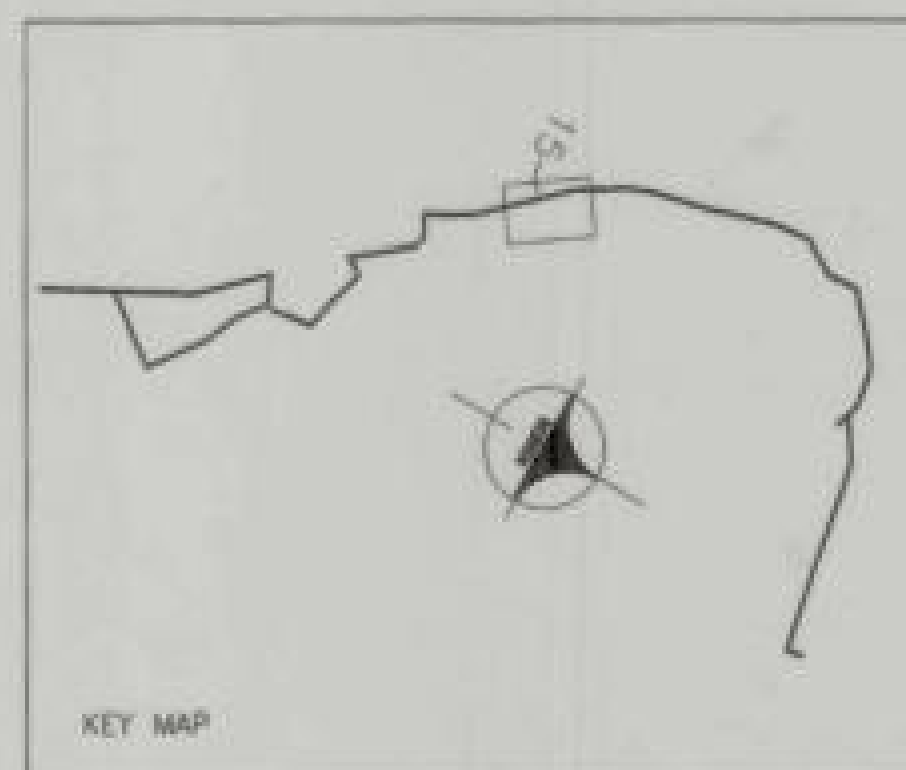

FED. AID. H'WAY PROJECT NO.	AC. PROJECT CODE NO.	HIGHWAY P. R. NUM.	MUNICIPALITY	ISLAND	FISCAL YEAR	SHEET NO.	TOTAL SHEETS
STP-ENHA-(2)	AC-500023	P.R.-115	RINCON	P.R.	1997-98	16	24




HORIZONTAL & VERTICAL CONTROL STATION				
STATION	NORTH (Y)	EAST (X)	ELEVATION	DESCRIPTION
R-5454	57996.2913	84172.8571	1.830	STEEL ROD 1/2"
R-5455	57919.4588	84153.5422	2.086	STEEL ROD 1/2"
R-5483	57986.9193	84114.0153	1.866	STEEL ROD 1/2"
R-5523	58026.2442	84079.9019	2.543	STEEL ROD 1/2"
R-5558	58083.6850	84053.5364	3.456	STEEL ROD 1/2"
R-5583	58177.8782	84015.1982	2.922	STEEL ROD 1/2"
R-5637	58279.3283	83992.0580	2.024	STEEL ROD 1/2"

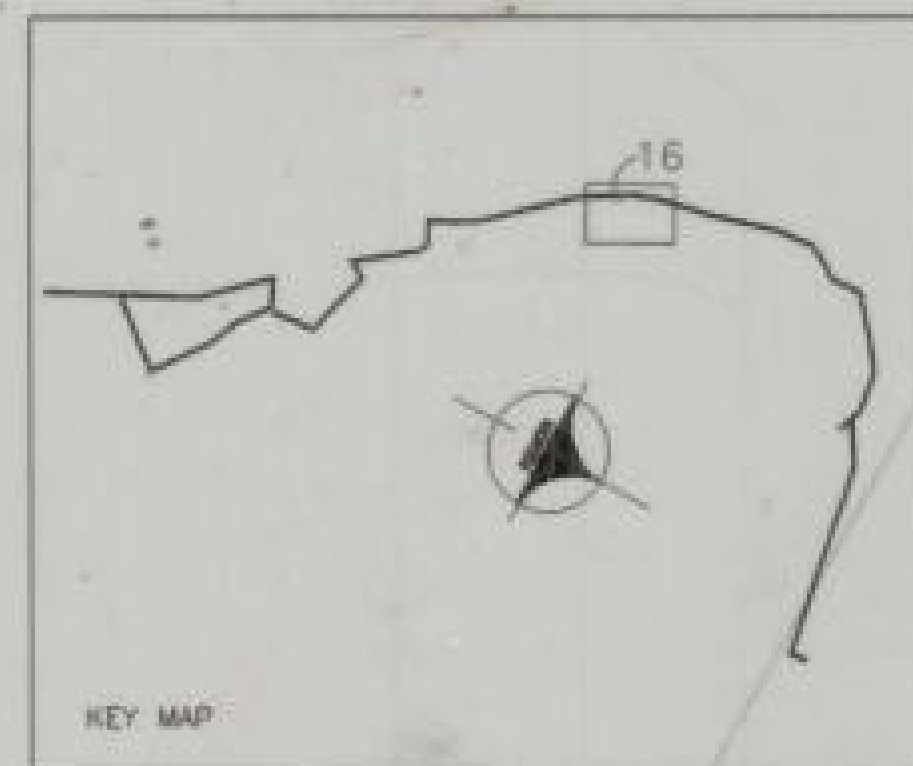

MARITIME ZONE LIMIT			
POINT	NORTH (Y)	EAST (X)	DESCRIPTION
COORDINATES			
5462	57910.9901	84186.8983	FENCE
5484	57919.3138	84180.9562	FENCE CORNER
5499	57933.2804	84152.8404	FENCE
5543	57986.9882	84130.1429	GATE
5534	57916.5049	84120.8233	FENCE
5527	58012.0545	84088.7016	FENCE
5580	58027.0226	84080.8673	FENCE
5562	58047.4270	84079.4282	FENCE
5563	58087.7187	84082.1443	FENCE CORNER
5581	58077.3794	84055.8188	FENCE CORNER
9880	58113.3577	84035.4298	CONCRETE MONUMENT
5603	58132.8833	84025.2496	FENCE
9881	58144.1451	84019.1747	CONCRETE MONUMENT
5604	58146.3620	84017.7818	FENCE
5638	58159.5467	84008.1637	FENCE CORNER
5670	58190.9882	84003.9711	IREC




FED. AID. H'WAY PROJECT NO.	AC. PROJECT CODE NO.	HIGHWAY P. R. NUM.	MUNICIPALITY	ISLAND	FISCAL YEAR	SHEET NO.	TOTAL SHEETS
STP-ENHA-(2)	AC-500023	P.R.-115	RINCON	P.R.	1997-98	17	24


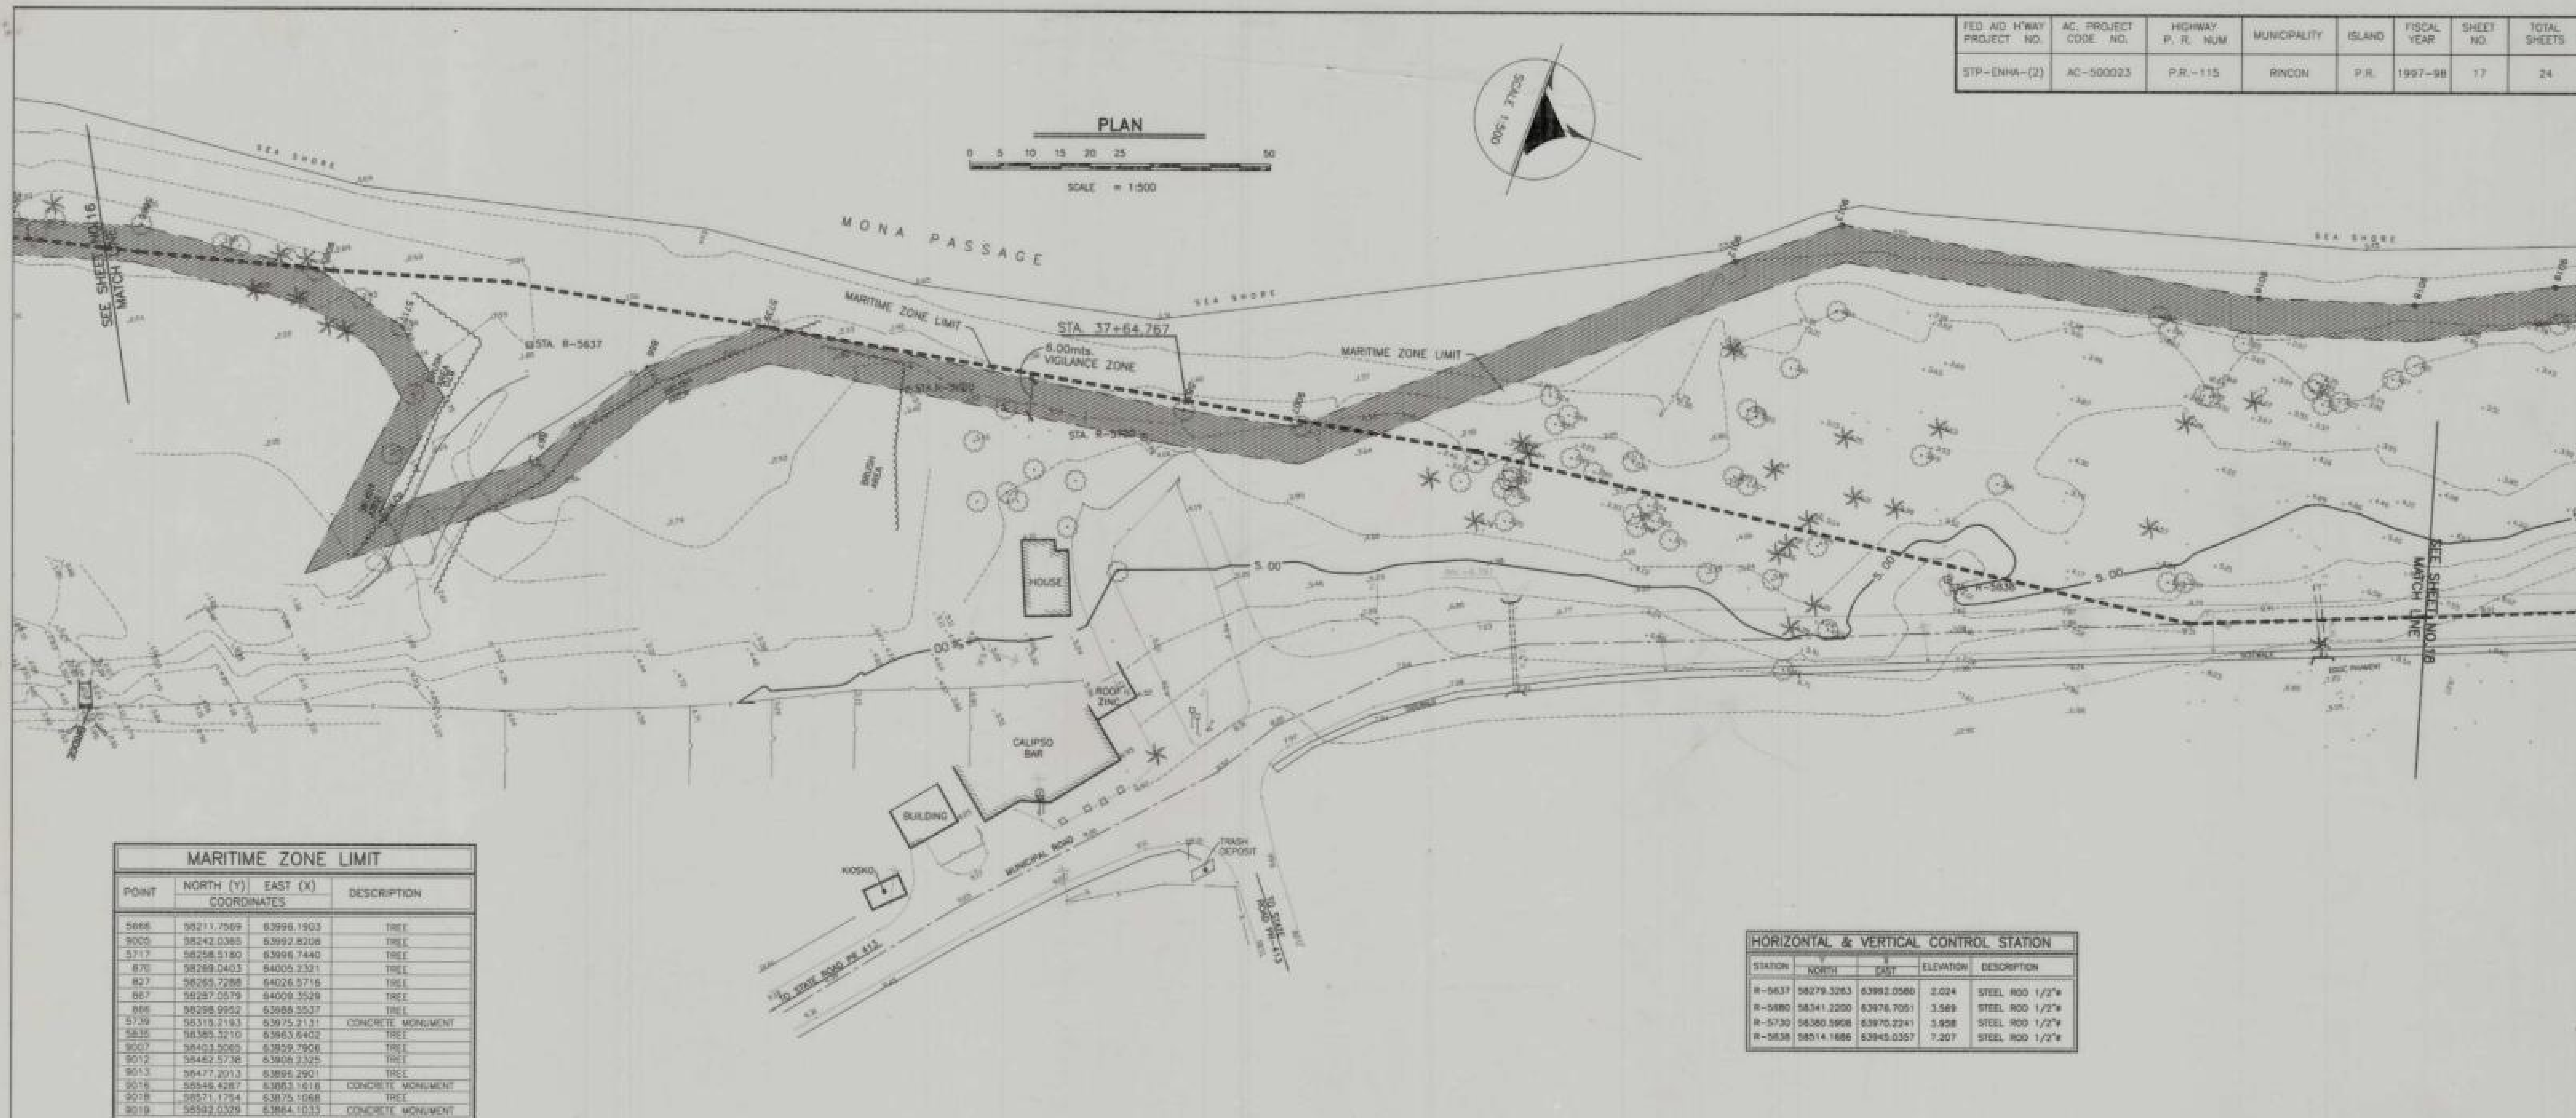


MARITIME ZONE LIMIT			
POINT	NORTH (Y) COORDINATES	EAST (X) COORDINATES	DESCRIPTION
5688	58211.7569	63996.1903	TREE
7000	58242.0385	63992.8208	TREE
5717	58258.5180	63996.7440	TREE
670	58269.0403	64005.2321	TREE
827	58265.7288	64026.5716	TREE
867	58287.0579	64006.3529	TREE
866	58288.9952	63988.5537	TREE
5739	58315.2193	63975.2131	CONCRETE MONUMENT
5835	58355.3210	63963.6402	TREE
9007	58403.9005	63959.2906	TREE
9012	58462.5738	63908.2325	TREE
9013	58477.2013	63886.2901	TREE
9016	58548.4287	63883.1618	CONCRETE MONUMENT
9018	58571.1754	63875.1068	TREE
9019	58592.0329	63884.1033	CONCRETE MONUMENT

HORIZONTAL & VERTICAL CONTROL STATION				
STATION	NORTH	EAST	ELEVATION	DESCRIPTION
R-5637	58279.3283	63992.0560	2.024	STEEL ROD 1/2"
R-5680	58341.2200	63976.7051	3.589	STEEL ROD 1/2"
R-5730	58380.9908	63970.2241	5.958	STEEL ROD 1/2"
R-5838	58514.1685	63945.0357	7.207	STEEL ROD 1/2"

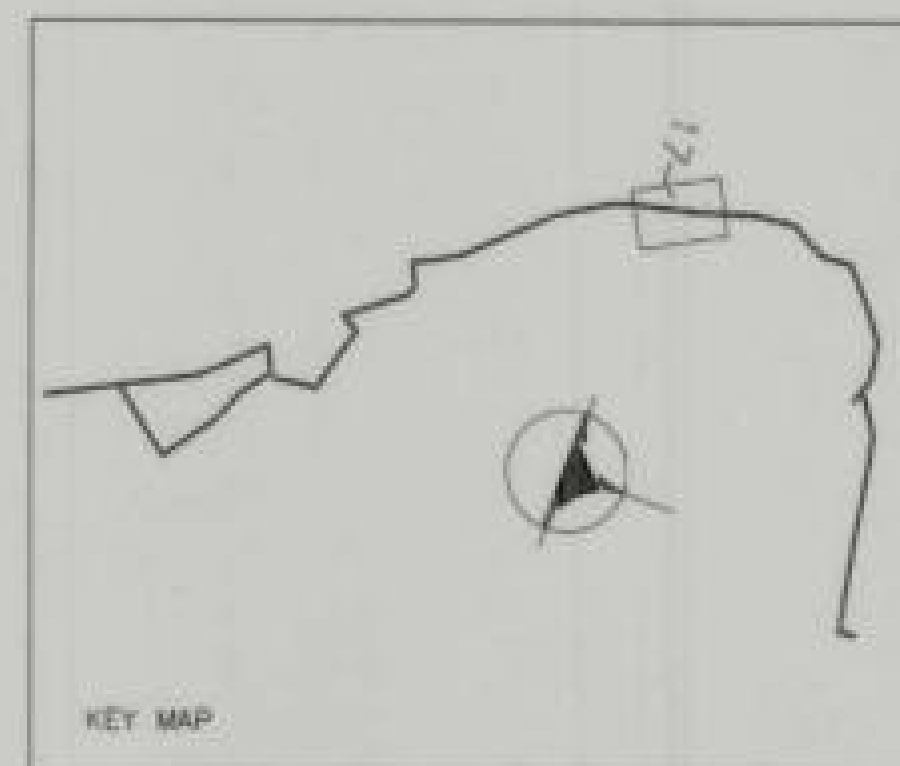

FED AID H'WAY PROJECT NO.	AC. PROJECT CODE NO.	HIGHWAY P. R. NUM	MUNICIPALITY	ISLAND	FISCAL YEAR	SHEET NO.	TOTAL SHEETS
STP-ENHA-(2)	AC-500023	P.R.-115	RINCON	P.R.	1997-98	18	24

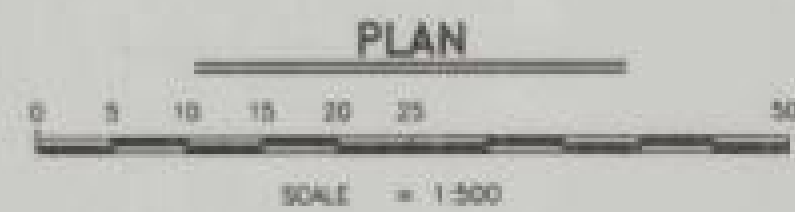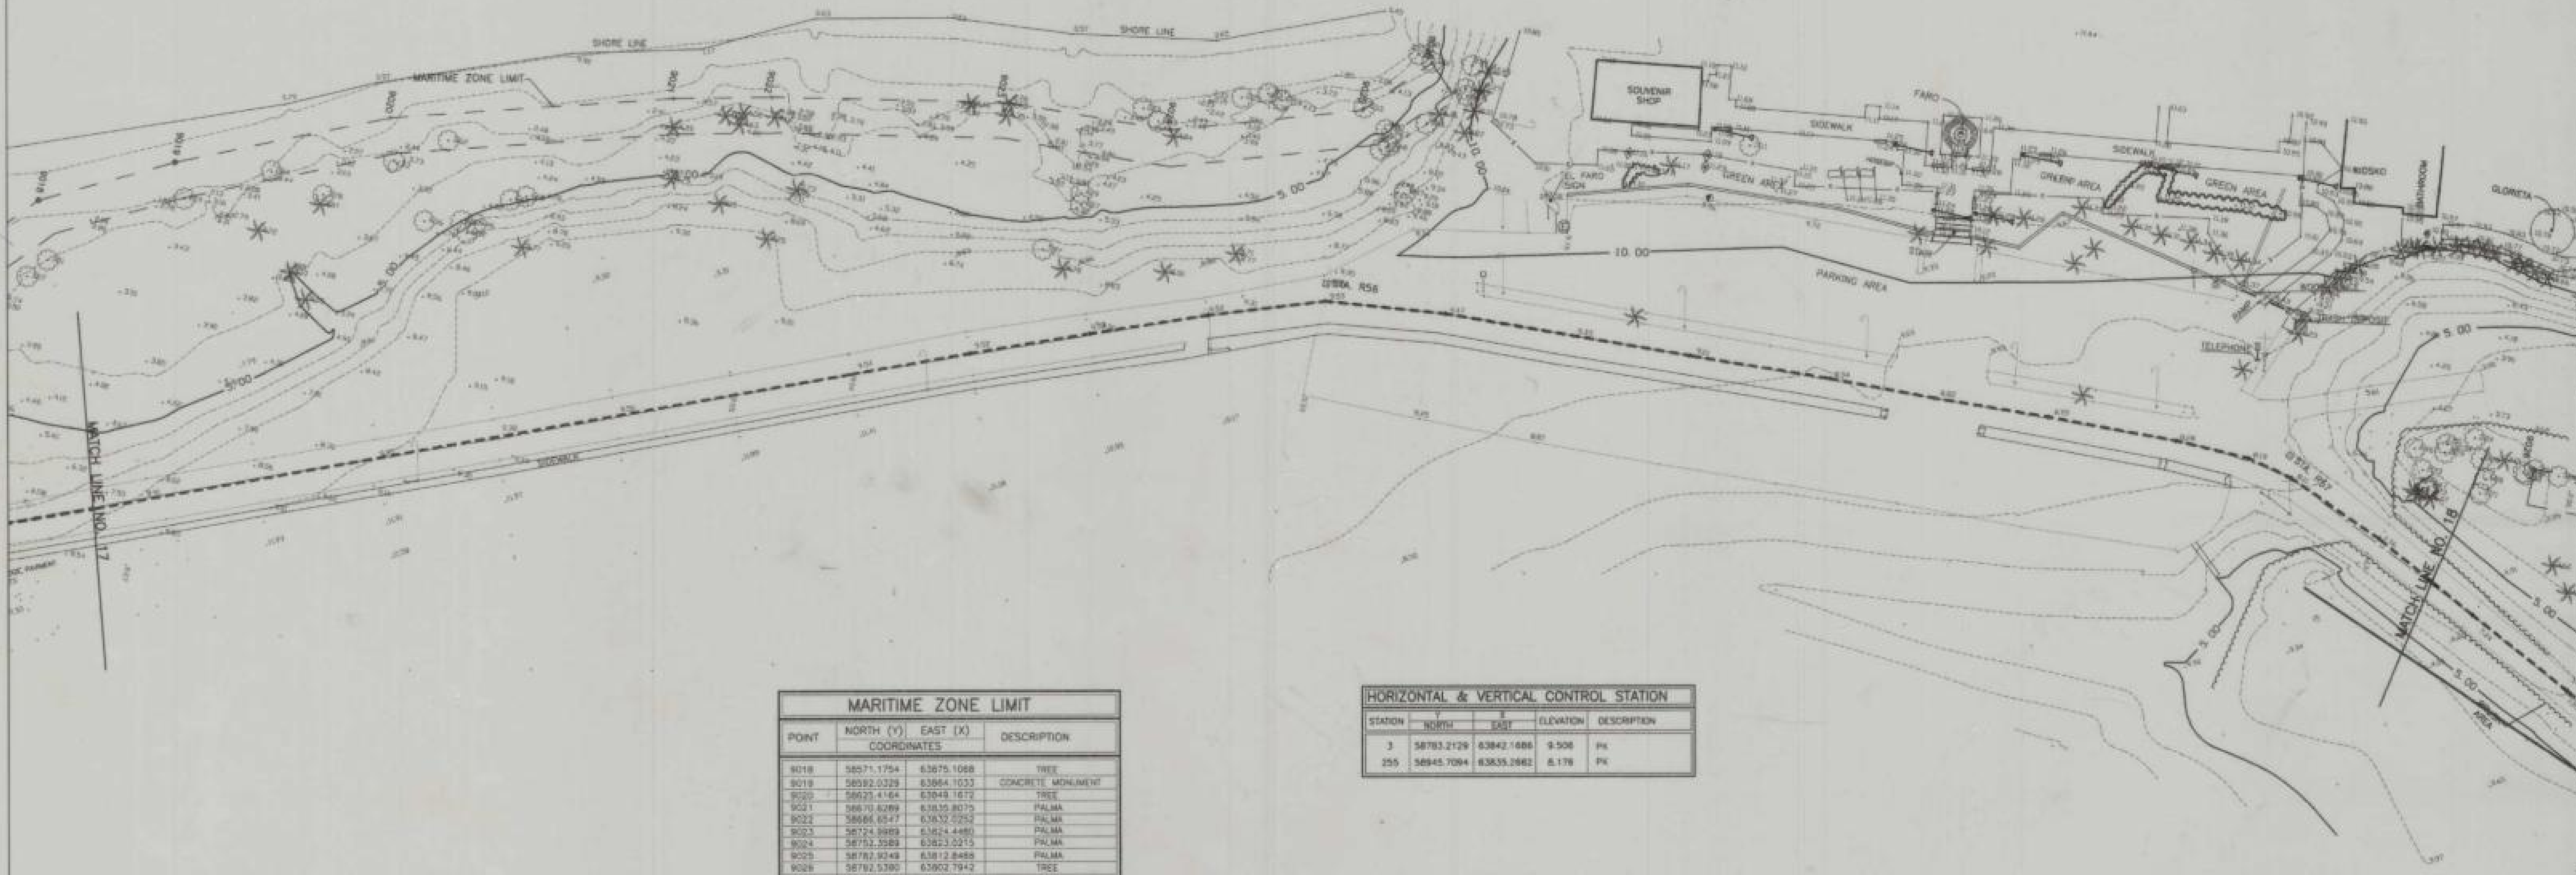


POINT	MARITIME ZONE LIMIT		DESCRIPTION
	NORTH (Y)	EAST (X)	
COORDINATES			
9018	58571.1754	63675.1088	TREE
9019	58582.0329	63664.1033	CONCRETE MONUMENT
9020	58623.4164	63649.1672	TREE
9021	58670.6269	63635.8075	PALMA
9022	58686.0547	63632.2252	PALMA
9023	58724.9989	63624.4486	PALMA
9024	58753.5589	63623.2215	PALMA
9025	58782.9348	63612.8488	PALMA
9026	58782.5380	63602.7942	TREE

HORIZONTAL & VERTICAL CONTROL STATION				
STATION	COORDINATES		ELEVATION	DESCRIPTION
	NORTH	EAST		
3	58783.2129	63842.1686	9.506	PK
255	58845.7084	63835.2862	8.178	PK




Department of Transportation and Public Works
Puerto Rico Highway
and Transportation Authority

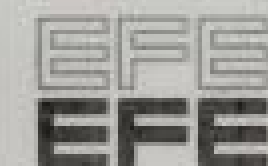

Eugenio Fernandez
ARCHITECTS
(809) 751-0440
Fax (809) 751-0411
P.O. Box 3423
Guayama, P.R. 00970
E mail: efgroup@aol.net

Consultores:
AGRIMENSORES ASOCIADOS

SENGU A. MORALES ANDRERO
LICENCIADO EN AGRIMENSURA
NÚMERO 111-1-800

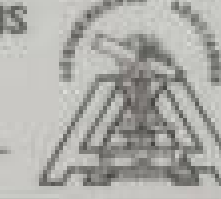

The Rincon Bicycle and Pedestrian Trail
Municipality of Rincon, Puerto Rico

Survey and Topographic AS-BUILT PLAN



Date	REVISIONS	File No.: 9703003.DWG
1 APRIL-16-99	GENERAL REVISIONS AND MARITIME ZONE	Plot Scale: 1:500
2		Date: July 6/98
3		Drawn By: D.P.F.
4		Revised By: D.P.F.

G
18

FED AID H'WAY PROJECT NO.	AC. PROJECT CODE NO.	HIGHWAY P. R. NUM.	MUNICIPALITY	ISLAND	FISCAL YEAR	SHEET NO.	TOTAL SHEETS
STP-ENHA-(2)	AC-500023	P.R.-115	RINCON	P.R.	1997-98	19	24




HORIZONTAL & VERTICAL CONTROL STATION				
STATION	NORTH	EAST	ELEVATION	DESCRIPTION
R-353	59119.1708	63920.3271	6.218	STEEL ROD 1/2"
R-647	59231.2343	63907.8384	2.708	STEEL ROD 1/2"
R-677	59287.8486	63942.6672	3.392	STEEL ROD 1/2"
R-718	59329.8207	63988.9293	4.425	STEEL ROD 3/8"
R-787	59341.8630	64032.7248	4.425	STEEL ROD 1/2"

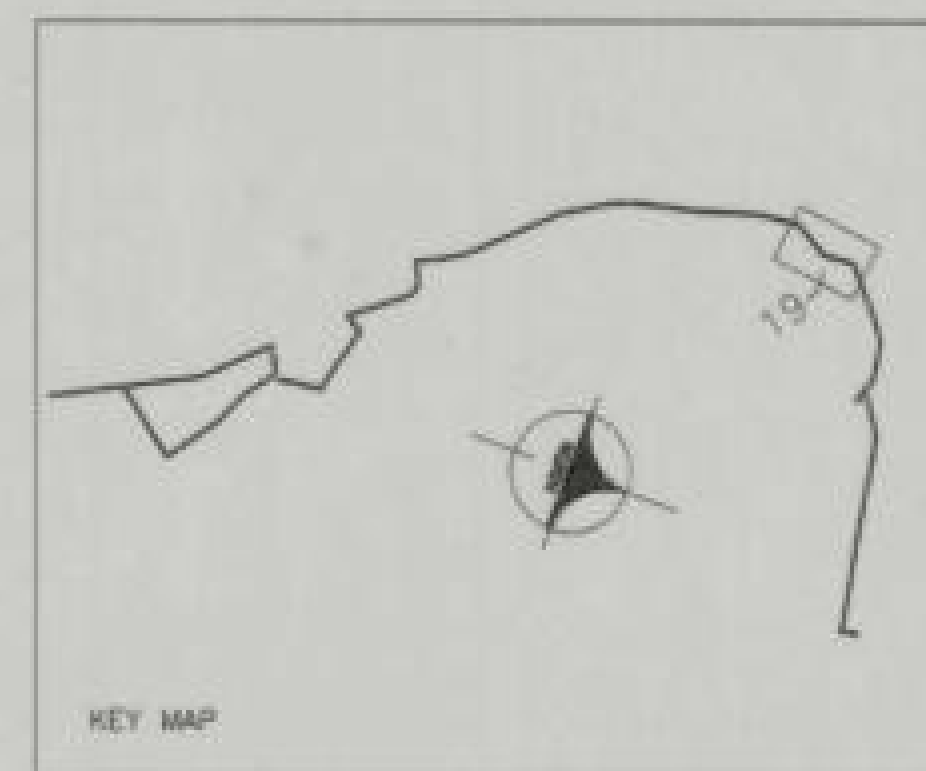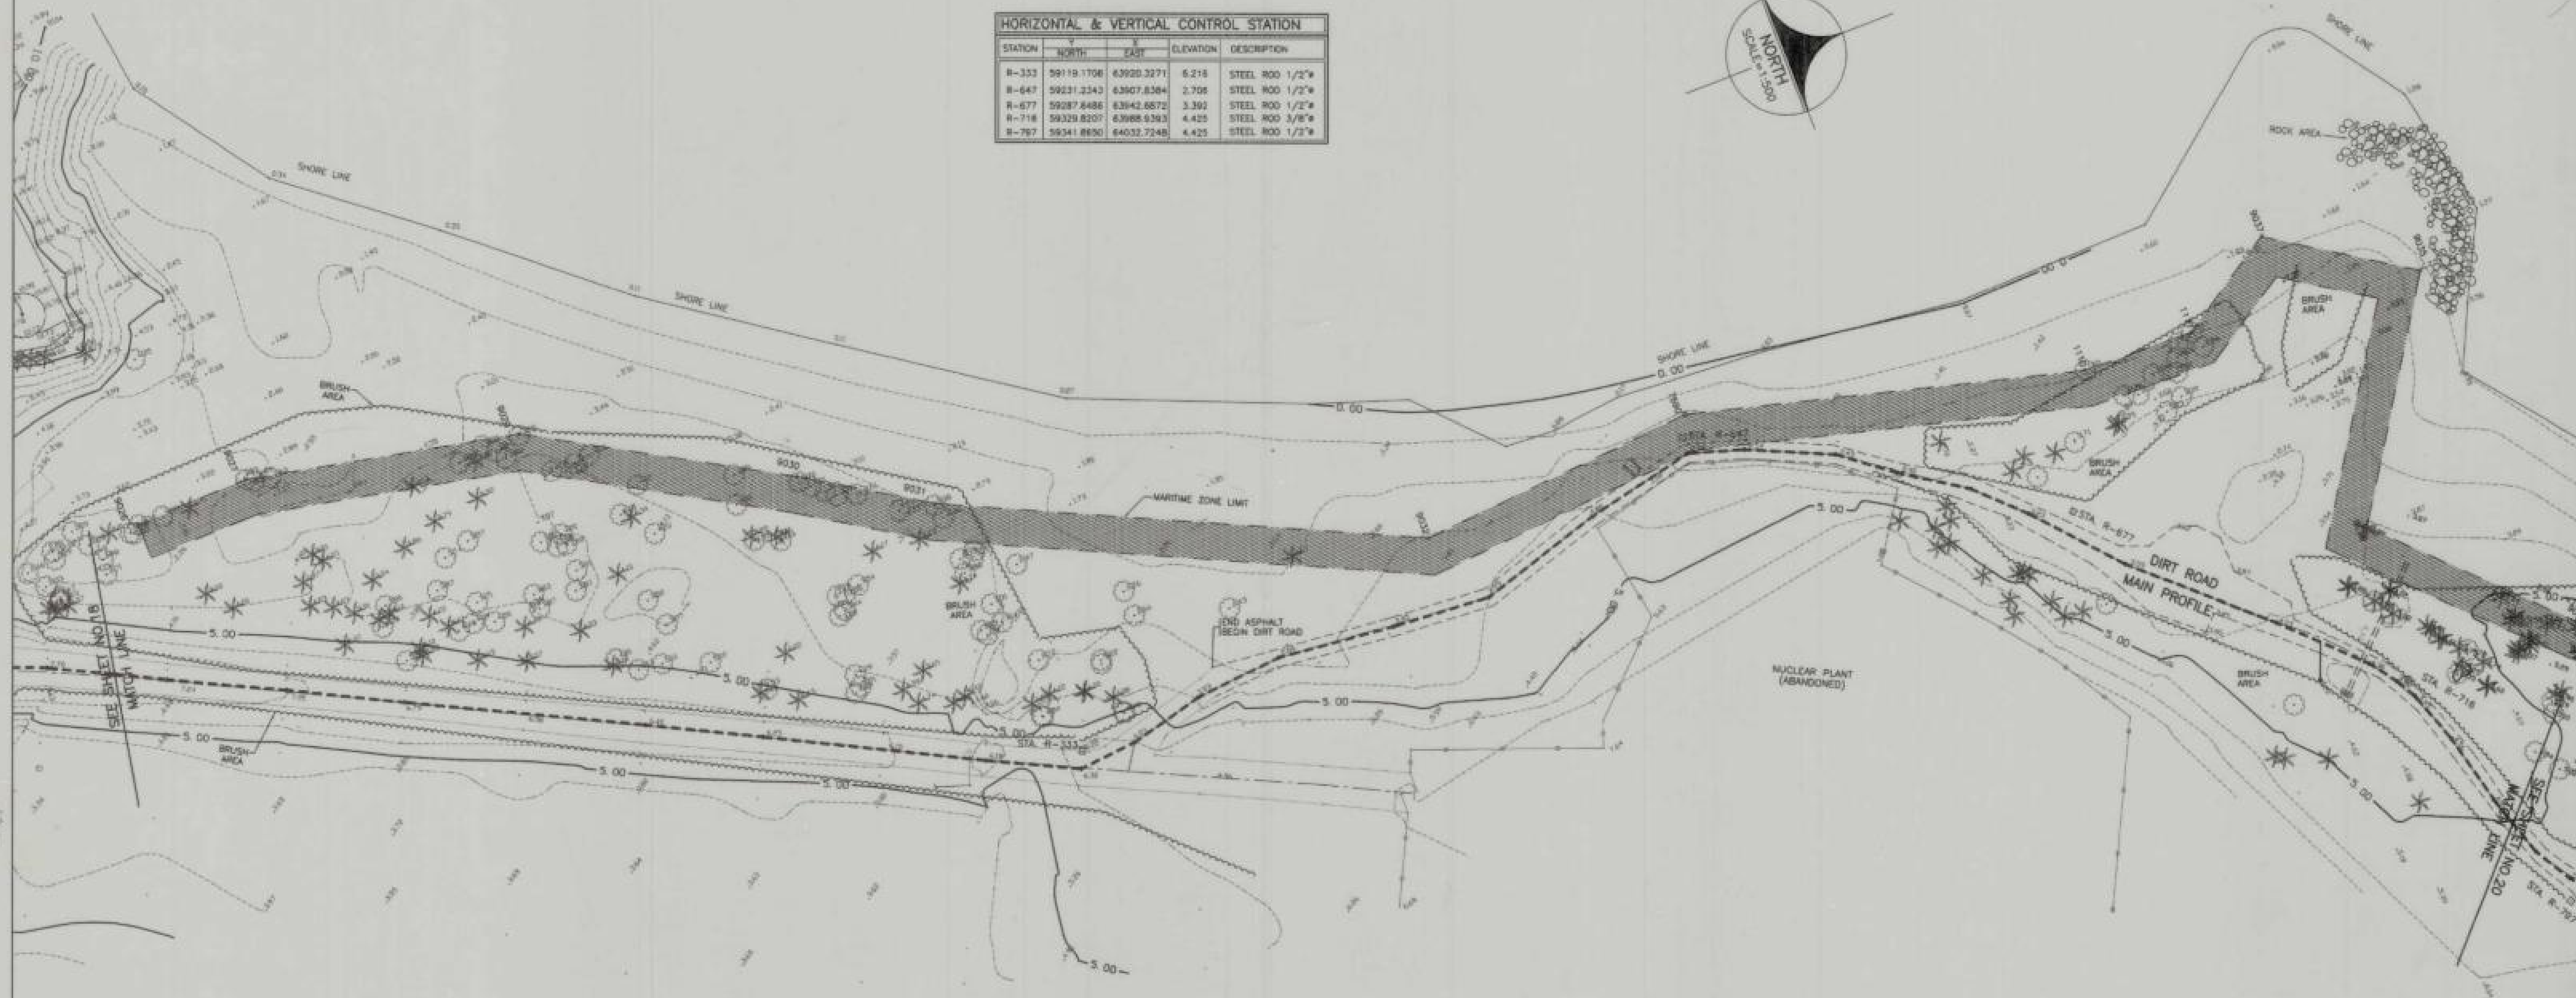

MARITIME ZONE LIMIT			
POINT	NORTH (Y) COORDINATES	EAST (X) COORDINATES	DESCRIPTION
9027	59885.7881	63828.6761	TREE
9028	59885.2923	63828.3089	TREE
9029	59890.4342	63837.8556	TREE
9030	59891.1961	63860.8810	TREE
9031	59117.0823	63873.4083	TREE
9032	59185.6322	63908.1271	TREE
9040	59232.4380	63954.4630	STEEL ROD 1/2"
1119	59287.8478	63971.5364	TREE
1117	59316.6735	63922.1000	TREE
9035	59318.5000	63929.4058	TREE
9037	59333.5068	63911.3417	STEEL ROD 1/2"
9038	59359.6787	63910.3625	STEEL ROD 1/2"
9039	59360.7818	63918.0722	STEEL ROD 1/8"
9036	59332.3644	63982.7508	TREE
9040	59359.4884	63988.8439	PALMA



Department of Transportation and Public Works
Puerto Rico Highway
and Transportation Authority

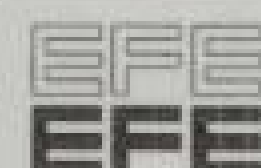

Eugenio Fernandez
Arquitecto

(809) 751-0440
Fax: (809) 751-0411
P.O. Box 3423
Guayama, P.R. 00970
E-mail: efgroup@comcast.net

AGRIENSORES ASOCIADOS
SOLICITUD DE REGISTRO DE DISEÑO DE OBRA
TEL: 786-1454
SOLICITUD DE REGISTRO DE DISEÑO DE OBRA
SOLICITUD DE REGISTRO DE DISEÑO DE OBRA



The Rincón Bicycle and Pedestrian Trail
Municipality of Rincon, Puerto Rico

THE SHEET
SURVEY AND TOPOGRAPHIC AS-BUILT PLAN

Date	REVISIONS	File No.: 9703003.DWG
1 APRIL-18-99	GENERAL REVISIONS AND MARITIME ZONE	Plot Scale: 1:500
2		Date: July 8/98
3		Drawn By: D.P.F.
4		Revised


G
19

FED AID H'WAY PROJECT NO.	AC PROJECT CODE NO.	HIGHWAY P. R. NUM.	MUNICIPALITY	ISLAND	FISCAL YEAR	SHEET NO.	TOTAL SHEETS
STP-ENHA-(2)	AC-500023	P.R.-115	RINCON	P.R.	1997-98	20	24

HORIZONTAL & VERTICAL CONTROL STATION				
STATION	NORTH	EAST	ELEVATION	DESCRIPTION
R-797	59341.8850	64032.7248	5.589	STEEL ROD 1/2"
R-855	59439.4477	64055.2829	6.477	STEEL ROD 1/2"
R-858	59533.2222	64185.0803	5.873	STEEL ROD 1/2"
R-1047	59544.9170	64231.2787	5.898	STEEL ROD 1/2"
R-1116	59554.4348	64303.0368	5.871	STEEL ROD 1/2"



MARITIME ZONE LIMIT			
POINT	NORTH (Y)	EAST (X)	DESCRIPTION
9040	59359.4684	63889.8439	PALMA
9041	59383.6806	64011.2718	PALMA
7940	59403.31	64051.87	PALMA
7904	59410.39	64063.84	CONCRETE MONUMENT
7988	59419.35	64087.80	CONCRETE MONUMENT
7998	59433.48	64070.63	RETENTION WALL
7998	59443.71	64081.66	RETENTION WALL
8002	59460.30	64089.08	RETENTION WALL
8007	59475.36	64116.21	RETENTION WALL
8012	59491.57	64134.28	RETENTION WALL
8008	59492.39	64137.88	RETENTION WALL
8009	59496.11	64142.29	RETENTION WALL
8070	59516.76	64171.58	CONCRETE MONUMENT
8073	59528.82	64183.10	RETENTION WALL
8117	59533.20	64192.35	CONCRETE MONUMENT
9044	59537.5632	64201.5373	STEEL ROD 3/8"
9045	59533.6048	64211.5236	STEEL ROD 3/8"
9046	59539.1238	64222.8838	STEEL ROD 3/8"
8128	59542.83	64224.95	CONCRETE MONUMENT
9047	59546.2302	64226.3181	STEEL ROD 3/8"
8128	59547.52	64231.84	CONCRETE MONUMENT
9048	59543.0993	64238.2993	STEEL ROD 3/8"
9049	59548.1510	64253.6339	STEEL ROD 3/8"
9050	59549.0977	64270.4298	STEEL ROD 3/8"
8150	59543.8770	64278.3292	CONCRETE MONUMENT
8289	59542.4690	64289.7830	CONCRETE MONUMENT
8237	59545.2190	64298.3090	CONCRETE MONUMENT

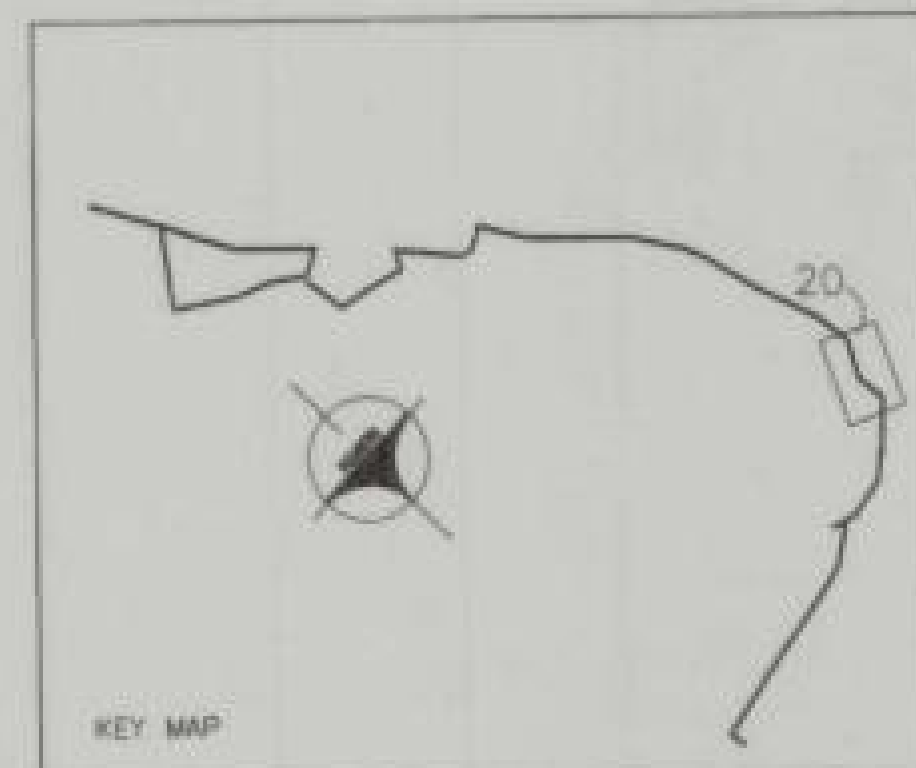


FED AID H'WAY PROJECT NO.	AC. PROJECT CODE NO.	HIGHWAY P. R. NUM.	MUNICIPALITY	ISLAND	FISCAL YEAR	SHEET NO.	TOTAL SHEETS
STP-ENHA-(2)	AC-500023	P.R.-115	RINCON	P.R.	1987-88	21	24



MARITIME ZONE LIMIT			
POINT	NORTH (Y)	EAST (X)	DESCRIPTION
9282	59554.8537	84308.3483	STEEL ROD 3/8"
9333	59553.3412	84305.0161	STEEL ROD 3/8"
9358	59555.1473	84348.0251	STEEL ROD 3/8"
9357	59556.8826	84362.0631	STEEL ROD 3/8"
9359	59560.4885	84382.0235	STEEL ROD 3/8"
9358	59558.8331	84384.2888	STEEL ROD 3/8"
8311	59553.75	84421.51	CONCRETE MONUMENT
9359	59562.6884	84426.7490	STEEL ROD 3/8"
8472	59557.25	84478.41	CONCRETE MONUMENT
9359	59558.8381	84428.3800	STEEL ROD 3/8"
9358	59574.5182	84448.8545	STEEL ROD 3/8"
8319	59576.75	84485.85	RETENTION WALL
8322	59587.35	84488.88	RETENTION WALL
8324	59594.48	84507.77	RETENTION WALL
8348	59595.25	84507.88	RETENTION WALL
8358	59604.50	84514.81	RETENTION WALL
8358	59614.13	84582.45	RETENTION WALL
8348	59630.08	84584.18	RETENTION WALL
8344	59648.88	84600.75	RETENTION WALL
8342	59671.51	84617.88	RETENTION WALL
8341	59686.78	84672.48	RETENTION WALL

HORIZONTAL & VERTICAL CONTROL STATION				
STATION	NORTH	EAST	ELEVATION	DESCRIPTION
R-1118	59554.8548	84303.0368	5.871	STEEL ROD 1/2"
R-1351	59555.0312	84401.4317	6.241	STEEL ROD 1/2"
R-1408	59575.2458	84485.2780	8.115	STEEL ROD 1/2"
R-1474	59588.8100	84512.7772	8.415	STEEL ROD 1/2"
R-1491	59625.9180	84574.6386	5.918	STEEL ROD 1/2"
R-1475	59629.9689	84610.8242	5.879	STEEL ROD 1/2"
R-1531	59681.3982	84675.8089	5.941	STEEL ROD 1/2"

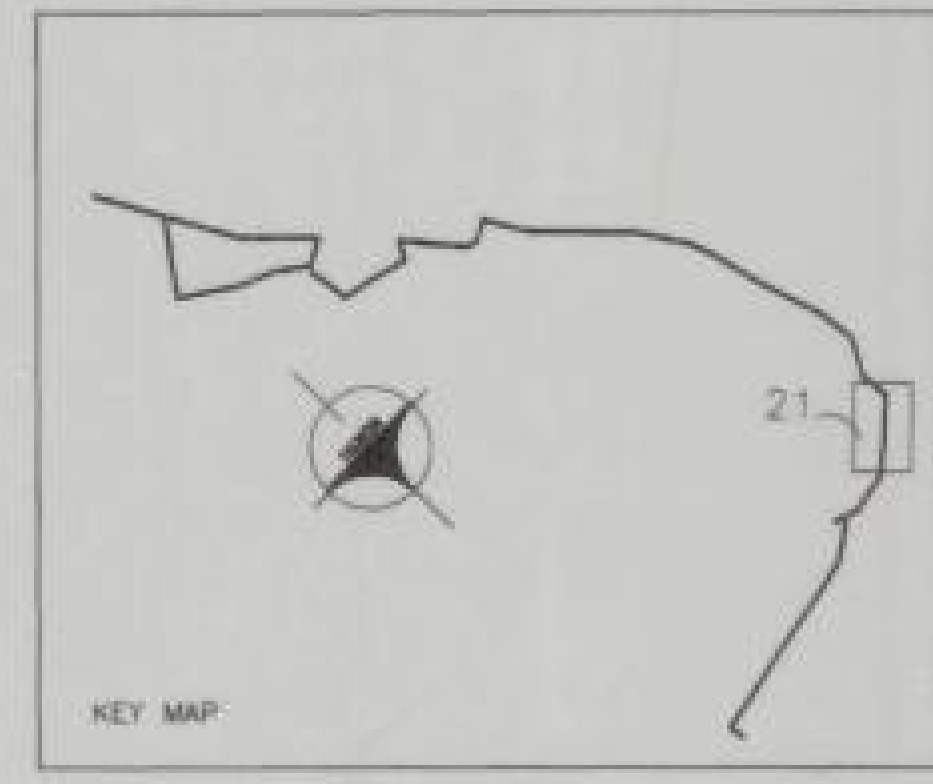

DEPARTAMENTO DE RECURSOS NATURALES Y AMBIENTALES

APROBADO

PROYECTO: C-396-161

UNIDAD ACTIVA: 2000-0000-0000

PROYECTO: EXPEDICION DE PLANO

FECHA: 21 de Julio de 1988

REVISADO POR: [Signature]

REVISADO POR: [Signature]


REVISADO POR: [Signature]

AS

FED. AID. HWY. PROJECT NO.	AC. PROJECT CODE NO.	HIGHWAY P. R. NUM.	MUNICIPALITY	ISLAND	FISCAL YEAR	SHEET NO.	TOTAL SHEETS
STP-ENHA-(Z)	AC-500023	P.R.-115	RINCÓN	P.R.	1997-98	22	24



MARITIME ZONE LIMIT			
POINT	NORTH (Y) COORDINATES	EAST (X) COORDINATES	DESCRIPTION
8700	59722.4030	84787.8800	CONCRETE MONUMENT
878	59732.5248	84784.4204	CONCRETE MONUMENT
879	59739.5422	84786.3688	CONCRETE MONUMENT
880	59739.1851	84817.5244	CONCRETE MONUMENT
8801	59738.4370	84853.8620	CONCRETE MONUMENT

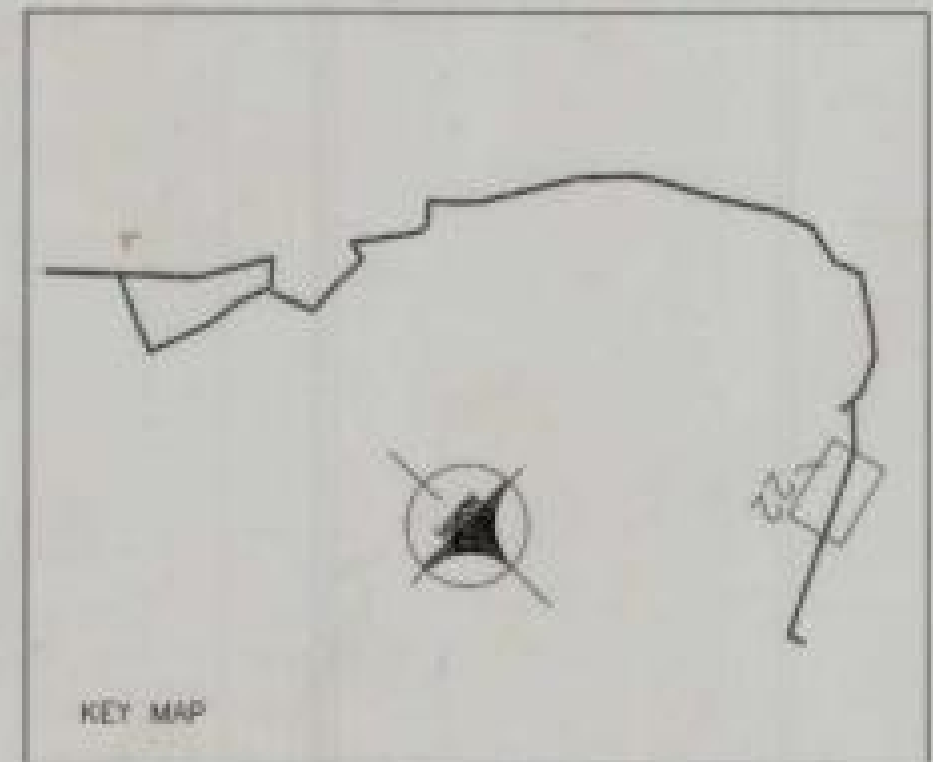

HORIZONTAL & VERTICAL CONTROL STATION				
STATION	NORTH	EAST	ELEVATION	DESCRIPTION
R-1531	59681.5882	84675.8089	5.841	STEEL ROD 1/2"
R-1611	59702.9708	84743.5012	6.408	STEEL ROD 1/2"
R-1650	59717.3640	84819.3806	6.557	STEEL ROD 1/2"
R-1680	59729.4338	84884.5345	7.177	NAIL P.C.
R-1827	59749.2487	85011.4782	8.238	NAIL P.C.

